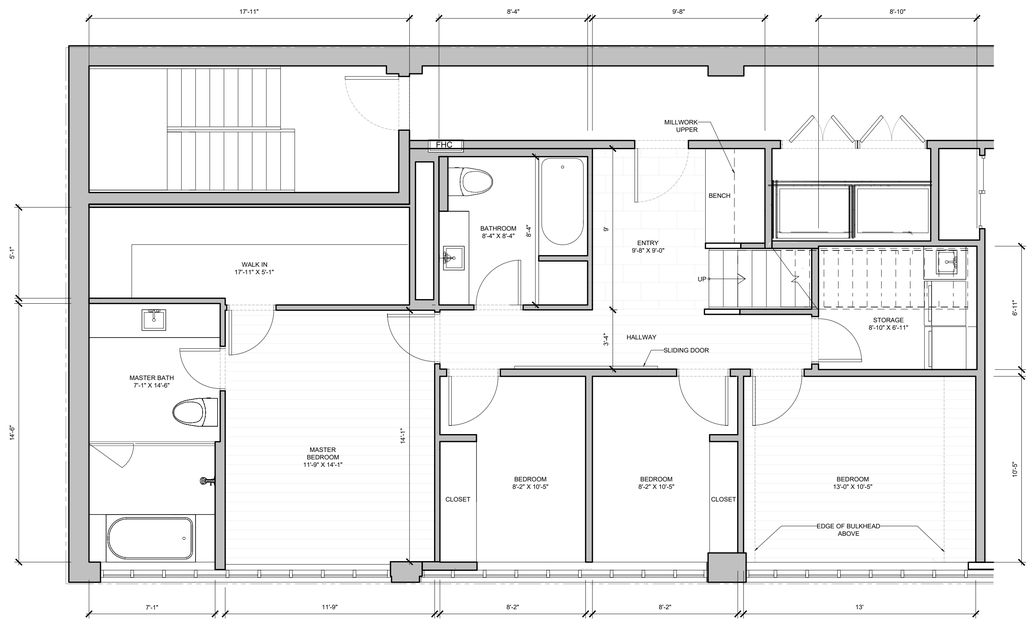

P1 4TH LEVEL - AS BUILT

1/4" = 1'-0"

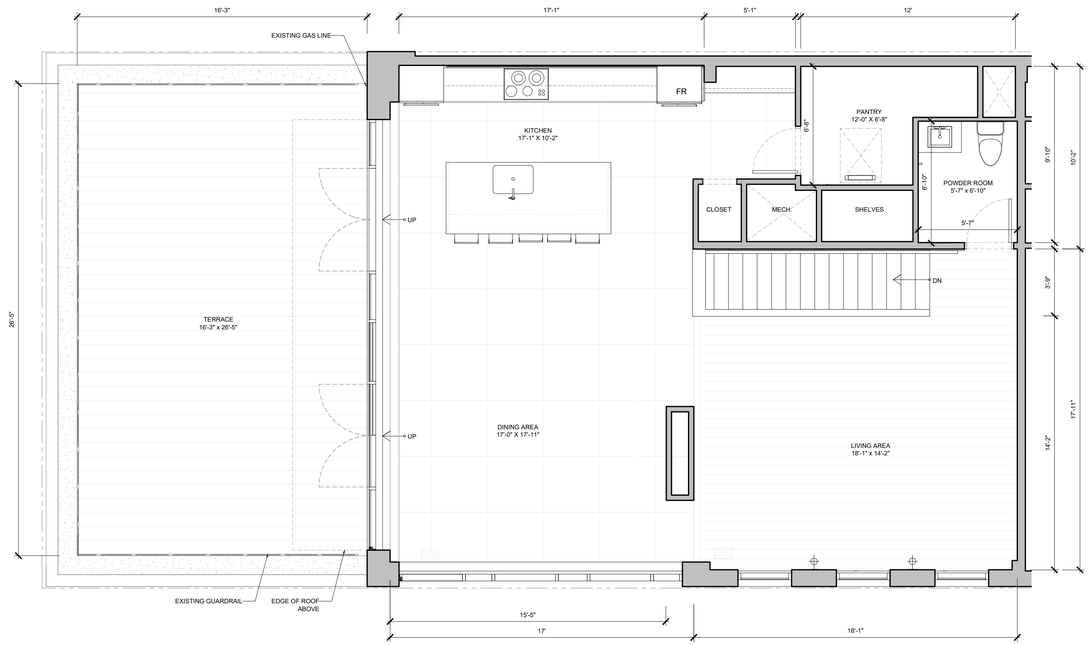

P2 5TH LEVEL - AS BUILT

1/4" = 1'-0"

GENERAL NOTES:

-PREPARE AREAS FOR NEW FINISHES AND HARDWARE WHERE WALLS, FINISHES, OR HARDWARE ARE BEING REMOVED UNDER THE SCOPE OF WORK.

VISIONARY

540 COLLEGE ST
TORONTO, ON

4TH / 5TH LEVEL - AS BUILT

SCALE 1/4" = 1'-0"

DATE: April 11, 2025

DRAWING # 1-00

N